


SPECIFICATION

ALL STEELWORK TO BE S355

FINISH:
STEELWORK: SNAP YELLOW RAL 1018
HANDRAIL: ANOLOCK 543
GLASS: TOUGHENED LAMINATED

ALL VISIBLE CSK FIXINGS TO BE
OVER CSK, FILLED & PAINTED OVER

3	AB00	AS BUILT	28-04-23	RL	LG
2	C00	FOR CONSTRUCTION	06-01-23	RL	LG
1	A00	FOR APPROVAL	30-09-22	RL	LG
REV No	REV MARK	REVISION DESCRIPTION	REV DATE	CRT BY	CHK BY

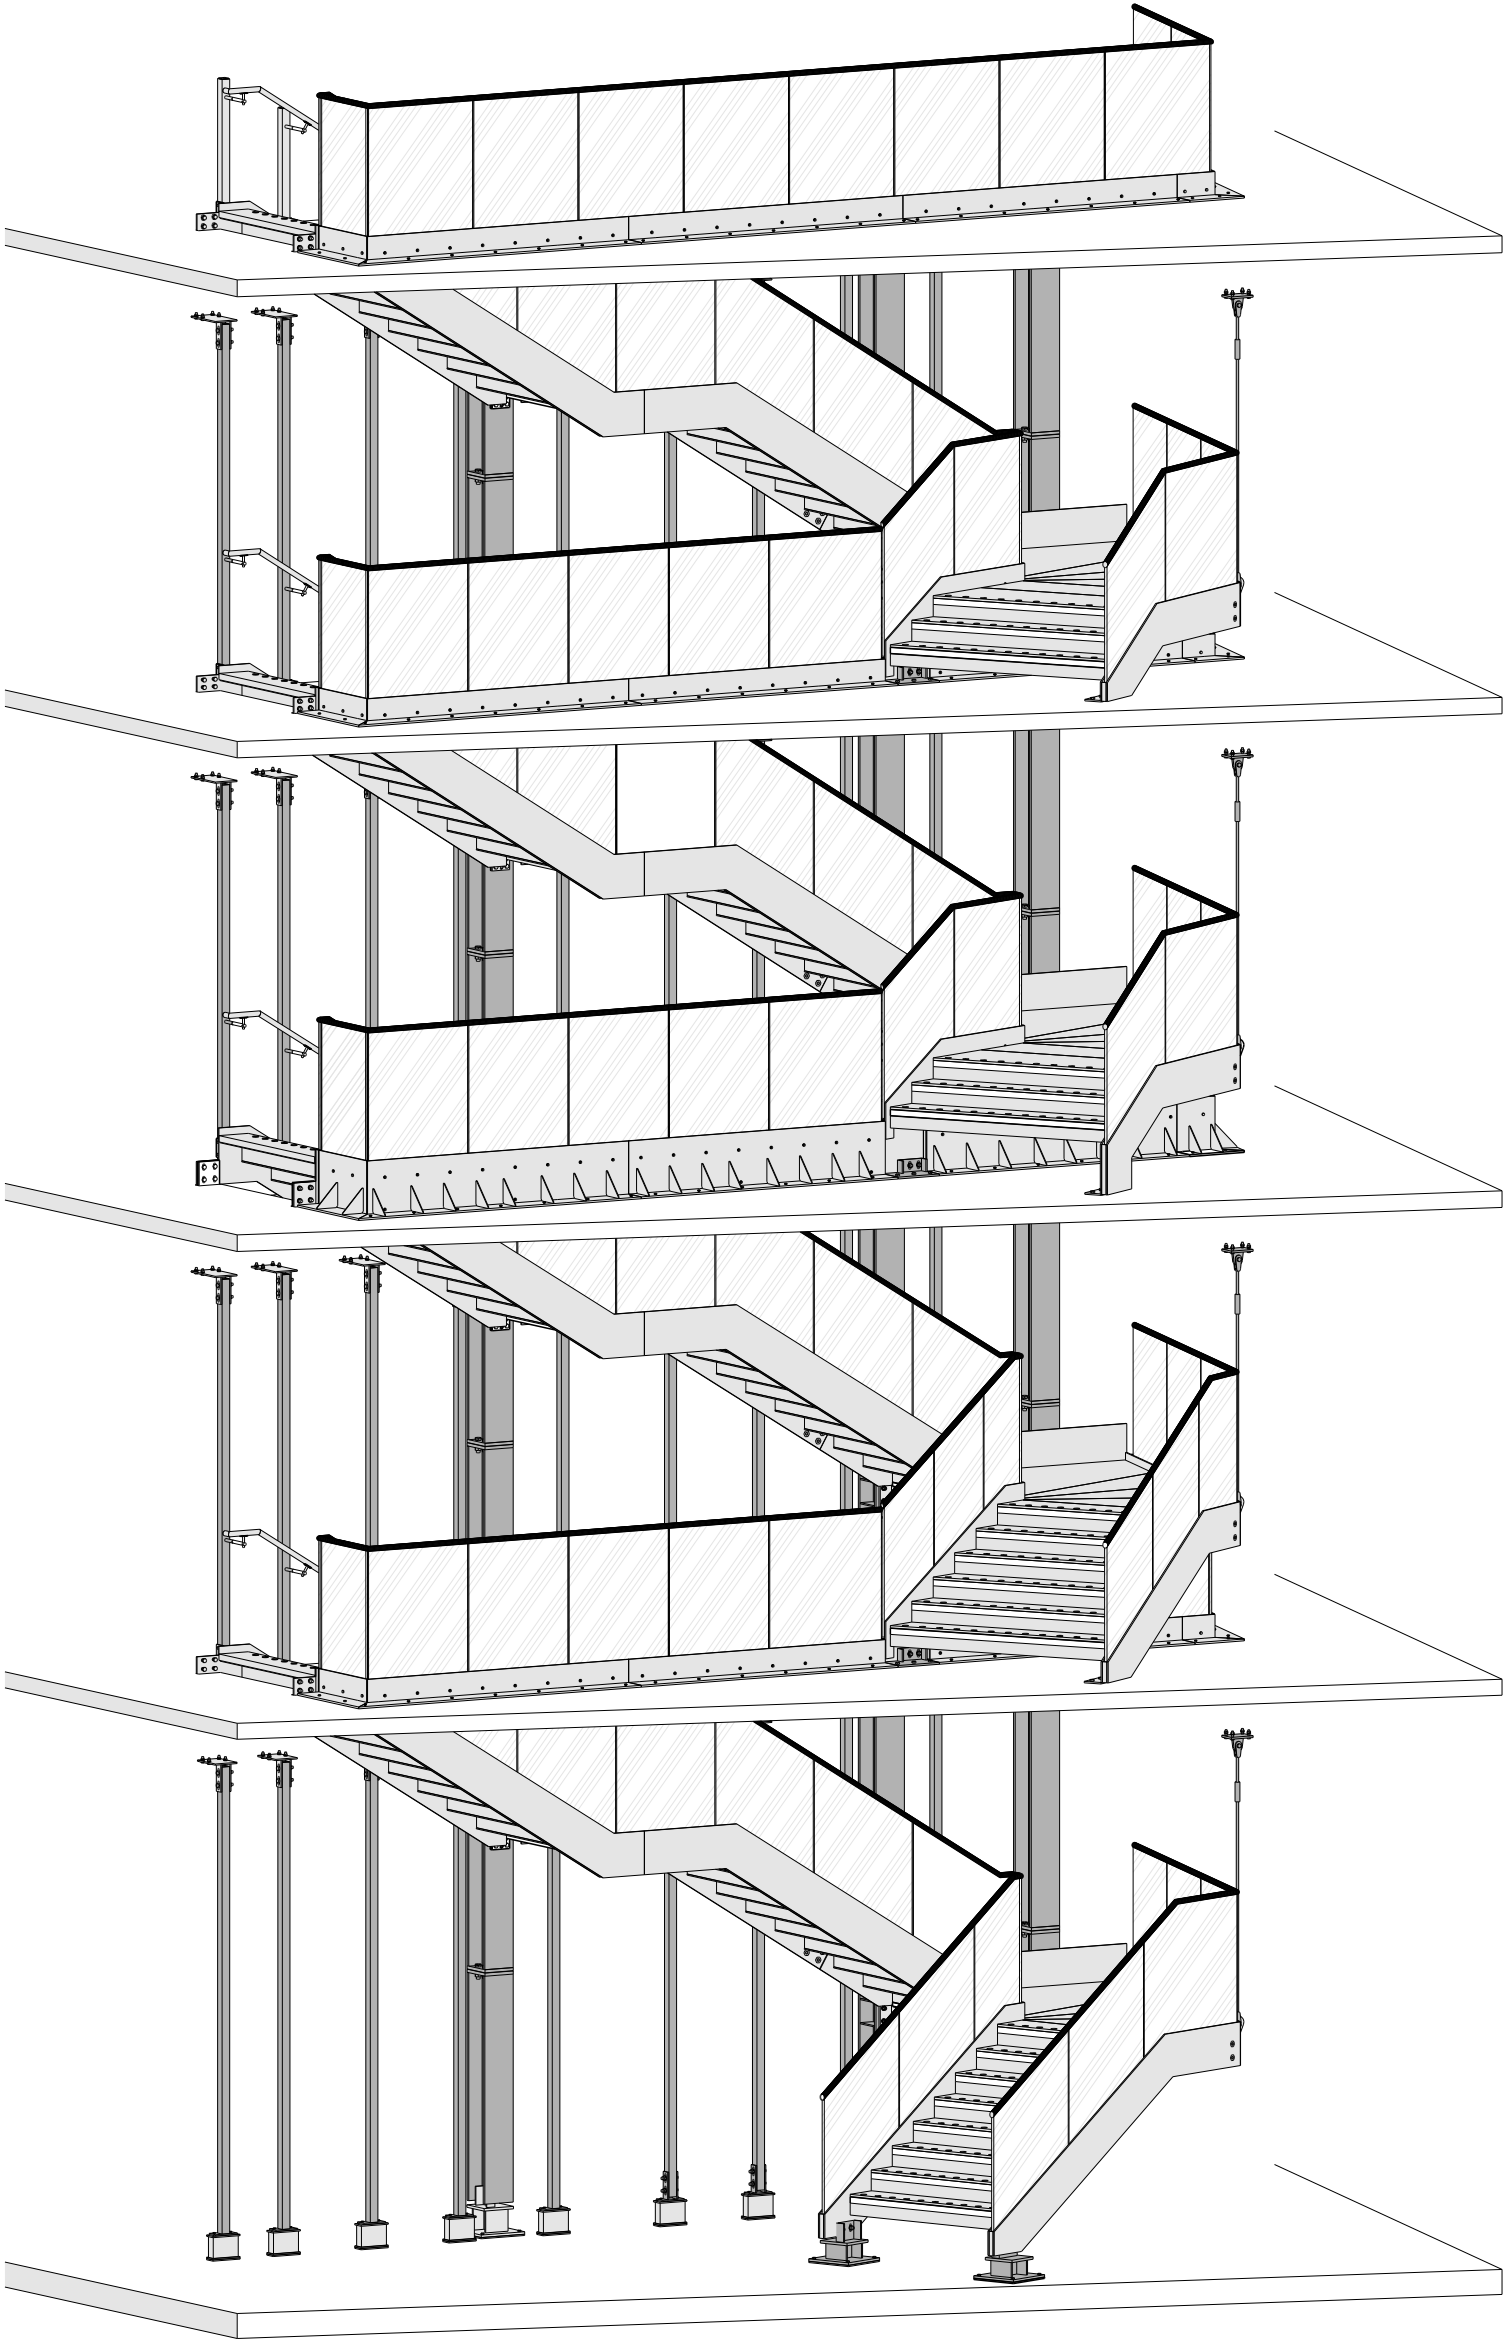

ISOMETRIC VIEW
FINISHES OMITTED

LISTED BELOW ARE THE DRAWING No's USED TO CREATE THIS DRAWING :	
ARCHITECTS DRAWINGS USED :	
ENGINEERS DRAWINGS USED :	
SITE SURVEY DRAWINGS USED :	
GENERAL NOTES :	
1. Grades for all mild steel standard sections to be in accordance with BS EN 10025-2 ~ S355-JR UNO	
2. All fitting plates also to BS EN 10025-2 ~ S355-JR UNO	
3. All hollow sections to be in accordance with BS EN 10210-1 (Hot) & 10219-1 (Cold) ~ S355-J2H UNO	
4. Non-preloaded bolt assemblies to BS EN 15048-1	
Pre-loaded bolt assemblies to BS EN 14399-1 (eg.HSFG) ~ 8.8 UNO	
5. All specified weld sizes are given as leg length	
6. Execution Class 2	
DO NOT SCALE FROM DRAWING - If in doubt, ask!	
STATUS :	
AS BUILT	
WESSEX FABRICATIONS LTD	
STEEL FABRICATIONS STEEL ERECTION ARCHITECTURAL METALWORK	
Unit 2c, Deer Park Industrial Estate, Knowle Lane, Fair Oak, Eastleigh, Hampshire, SO50 7DZ. Phone: 02380 602777 Fax: 02380 696888 Email: info.wessexfabricationsltd.co.uk	
CLIENT :	
Structuritone	
PROJECT :	
Snap Farringdon	
TITLE :	
FEATURE STAIRCASE	
ISOMETRIC VIEW	
FULL STAIR	
DRAWN BY : RL [DDM]	DATE DRAWN : 12-08-22
CHECKED BY : 0 [DDM]	DATE CHECKED :
SCALE : 1:60	REVISION : AB00
DRAWING No. : SBB-4510-ZZ-03-DR-X-00001	